AND ZONING VARIANCE ON PROPERTY LOCATED ON THE NORTH * EAST SIDE OF DUNDALK AVENUE, 300' SOUTHEAST OF THE CENTER- *

7TH COUNCILMANIC DISTRICT

BALTIMORE COUNTY LINE OF SOLLERS POINT ROAD + CASE NO. 89-523-XA (7910 DUNDALK AVENUE) 12TH ELECTION DISTRICT

This matter comes before the Board as an appeal by the Petitioner/Appellant, Richard A. Jones, from a decision by the Zoning Commissioner dated June 26, 1989. Within his decision, the Zoning Commissioner denied the Appellant's Petition for Special Exception to permit a service garage on the subject property. The Commissioner also denies the Appellant's Petitions for Zoning Variances, which requested relief from the side yard setback requirements, as well as relief from parking requirements.

During the interim period from the filing of the appeal to the hearing before this Board, it was determined that the property was located within the Chesapeake Bay Critical Area. Thus, it was agreed upon by the parties that the subject Petitions be submitted to Baltimore County's Department of Environmental Protection and Resource Management (DEPRM) for evaluation and comment. At the hearing before this Board, it was proffered that extensive negotiations involving all parties interested in the appeal took place. As a result of these discussions, the parties proposed that the Petitions be granted, subject to certain restrictions.

Richard A. Jones, Case No. 89-523-XA

As to the Petition for Special Exception, this Board is required to consider same in accordance with Section 502.1 of the Baltimore County Zoning Regulations (BCZR). There was testimony proffered by Appellant's Counsel that the Petitioner would testify that the proposal was in compliance with the numerous requirements of Section 502.1 of the BCZR. Specifically, that the proposal would not be detrimental to the health, safety, and general welfare of the area nor adversely affect the subject locale. In addition to the Petitioner's testimony in this respect, the Board also received the proffered testimony of Norman E. Gerber, zoning/planning expert, who was present at the hearing. Mr. Gerber also believes that the Special Exception should be granted and that same complies with the requirements of Section 502.1 of the BCZR. In addition to the proffered testimony, the Board has examined Petitioner's Exhibit No. 1, the site plan for this project, which also shows the subject locale. Based upon the above cited proffers, as well as a review of Petitioner's Exhibit No. 1, we believe that the proposed use is ideal for this site. That is, the building that will house this site is an older structure which is within close proximity of other commercial uses as well as utility easements and a pumping station operated by Baltimore County. Thus, we do not believe that this proposal would have an adverse impact above and beyond that inherently associated with such a use.

Thus, the use complies with the test determined by the

Richard A. Jones, Case No. 89-523-XA

Appellate Courts of this state in Schultz v. Pritts, 432 A.2d 1319

As to the proposed variances, we believe that they should be granted as well. The proffered testimony before us disclosed that the building which will house the proposed service garage encompasses nearly the entire property. This building in fact predates the adoption of zoning regulations within Baltimore County. Based upon that testimony, we believe that the Petitioner has satisfied the requirements of Section 307 of the BCZR and that the variances should be granted.

Notwithstanding our decision, we are likewise persuaded that certain restrictions proposed by DEPRM through the Office of People's Counsel for Baltimore County should be imposed with the granting of this Special Exception. In our view, these reasonable restrictions will insure a safe operation of this facility. consistent with the spirit and intent of the County regulations. Thus, we shall grant the Petitions for Special Exception and Variances, with restrictions and will so order.

Upon the aforegoing Opinion, it is this _____26th day of June 1990 by the County Board of Appeals of Baltimore County ORDERED that the Petition for Special Exception for a service garage be and the same is hereby GRANTED subject to the following restrictions:

Richard A. Jones, Case No. 89-523-XA

- That the proposed earth dike and stone outlet structure not be built, but that additional trees and shrubs be planted in its place.
- 2. That a Forest Establishment Plan, provided by the Chesapeake Bay Watershed Forester, and a Forest Establishment Agreement be signed within 90 days.
- 3. That a letter be obtained from Baltimore County's Department of Recreation and Parks allowing the use of the property for the establishment of the trees.
- 4. That all toxic and hazardous materials including solids, liquids, and/or gas used or generated in the operation of the service garage shall be properly disposed of in accordance with the recommendation of Baltimore County's Division of Waste Management and the Department of Environmental Protection and Resource Management.

AND, IT IS FURTHER ORDERED that the Petition for Variance from Section 409.6.A.2. to permit 22 off-street parking spaces in lieu of the minimum 36 and the Petition for Variance from Section 232.2.b to permit side yard setbacks of 5' (East) and 5' (West) in lieu of the minimum 10' be and are hereby GRANTED.

Any appeal from this decision must be made in accordance with Rules B-1 through B-13 of the Maryland Rules of Procedure.

> COUNTY BOARD OF APPEALS OF BALTIMORE COUNTY Lawrence E. Schmidt, Acting Chairman

County Board of Appeals of Baltimore County COUNTY OFFICE BUILDING, ROOM 315 111 W. CHESAPEAKE AVENUE TOWSON, MARYLAND 21204 (301) 887-3180

June 26, 1990

S. Eric DiNenna, Esquire DiNenna, Mann & Breschi P.O. Box 10508 Towson, Maryland 21285-0508

Re: Case No. 89-523-XA (Richard A. Jones)

Dear Mr. DiNenna:

Enclosed please find a copy of the final Opinion and Order issued this date by the County Board of Appeals of Baltimore County in the subject matter.

> Linda Lee M. Kusyman LindaLee M. Kuszmaul Legal Secretary

Enclosure

cc: Mr. Richard A. Jones Mr. Joseph Ewing Ms. Sharon Gard People's Counsel for Baltimore County P. David Fields J. Robert Haines Ann M. Nastarowicz James E. Dyer W. Carl Richards, Jr. Docket Clerk - Zoning Arnold Jablon, County Attorney

PETITIONS FOR SPECIAL EXCEPTION * BEFORE THE AND ZONING VARIANCES - NE/S Dundalk Avenue, 300' SE of the c/l of Sollers Point Road (7910 Dundalk Aranue) * OF BALTIMORE COUNTY 12th Election Lastrict * Case No. 89-523-XA 7th Councilmanic District Richard A. Jones Petitioner

FINDINGS OF FACT AND CONCLUSIONS OF LAW

* * * * * * * * * *

The Petitioner herein requests a special exception to permit a service garage on the subject property and variances to permit 22 offstreet parking spaces in lieu of the required 36, and side yard setbacks of 5 feet for the east side and 6 feet on the west side, both in lieu of the required 10 feet, all as more particularly described in Petitioner's Exhibit 1.

The Petitioner appeared and testified. Appearing as a Protestant in the matter was Joseph Ewing on behalf of the Watersedge Improvement Association.

Testimony indicated that the subject property, known as 7910 Dundalk Avenue, is located within the Chesapeake Bay Critical Areas, and consists of 0.409 acres more or less zoned B.L.-C.N.S. Said property is currently improved with a strip shopping center. Petitioner testified the property was originally split zoned D.R. 5.5 and B.L.-C.N.S. until he was granted a reclassification and the property was rezoned to all B.L.-C.N.S. Testimony indicated the shopping center once consisted of a grocery store and liquor store in the front, a seafood warehouse in the center, and a movie theatre in the rear. Petitioner testified the front section is still used as a grocery store and liquor store operation while the center and rear portions of the building are currently vacant. Petitioner propos-

es operating a automotive body and fender repair shop out of the center section and using the rear portion of the building for the storage of damaged and disabled vehicles awaiting repair. Testimony indicated that if the relief were granted in the special exception, variances would be required to bring the property in compliance with the zoning regulations.

Mr. Ewing testified in general opposition to the use proposed. He indicated that a service garage at this location would result in traffic congestion at the entrance to the site and parking congestion on the streets nearby due to the layout of the property. He further testified that the area presently experiences flooding problems from storm water runoff and that the use proposed would only aggravate existing problems.

It is clear that the B.C.Z.R. permits the use proposed in a B.L.-C.N.S. zone by special exception. However, it must be determined if the conditions as delineated in Section 502.1 are satisfied.

The Petitioner had the burden of adducing testimony and evidence which would show that the proposed use met the prescribed standards and requirements set forth in Section 502.1 of the B.C.Z.R. In fact, the Petitioner did not produce any evidence or testimony in support of the relief requested. Petitioner's testimony did not address the requirements set forth in Section 502.1 with respect to special exception requests and was unable to show that the use proposed would be conducted without real detriment to the neighborhood and would not adversely affect the public interest. There was no evidence or testimony to show that the proposed use at the particular location described by Petitioner's Exhibit 1 would not have an adverse impact above and beyond that inherently associated with such a special exception use, irrespective of its location within the zone. Schultz v. Pritts, 432 A.2d 1319 (1981).

In the opinion of the Zoning Commissioner, Petitioner has not met his burden of proof that the relief requested sufficiently complies with the requirements of Sections 307.1, 307.2, 502.1 and 500.14 of the Baltimore County Zoning Regulations (B.C.Z.R.). There was no evidence or testimony presented to indicate that the relief requested would not adversely affect the health, safety, and/or general welfare of the public, or that strict compliance with the B.C.Z.R. would result in practical difficulty and/or unreasonable hardship upon the Petitioner.

Petitioner has failed to presentt facts and evidence which would tend to establish that some special conditions or circumstances exist which are peculiar to the land or structures located within the Chesapeaka Bay Critical Areas of Baltimore County; that to deny the relief requested would result in practical difficulty, unreasonable hardship, or severa economic hardship upon the Petitioner; and that strict compliance with the Chesapeake Bay Critical Area requirements and the B.C.Z.R. would degrive the Petitioner of rights commonly enjoyed by other properties in similar areas within the Chesapeake Bay Critical Areas in Baltimore County. Petitioner must prove that the granting of the relief requested will not confer upon the Petitioner any special privilege that would be denied by the critical area regulations to other lands or structures within the Chesapeake Bay Critical Areas. Clearly, the relief requested must be in harmony with the general spirit and intent of the Critical Areas legislation for Baltimore County and conform to the requirements as set forth in Section 500.14 of the B.C.Z.R. The Petitioner's evidence does not established lish any of the legal standards set forth above, and therefore, the requested relief cannot be granted.

Pursuant to the advertisement, posting of the property, and public hearing on these Petitions held, and for the reasons given above, it appears that the requirements of Sections 307, 500.14 and 502.1 have not been met and the health, safety, and general welfare of the community shall be adversely affected. Therefore, the relief requested in the Petitions for Special Exception and Zoning Variance should be denied.

THEREFORE, IT IS ORDERED by the Zoning Commissioner for Baltimore County this day of June, 1989 that the Petition for Special Exception to permit a service garage on the subject property, and the Petition for Zoning Variance to permit 22 off-street parking spaces in lieu of the required 36, and side yard setbacks of 5 feet for the east side and 6 feet on the west side, both in lieu of the required 10 feet, in accordance with Potitioner's Exhibit 1, be and are hereby DENIED.

- 4-

JRH:bjs

Zoning Commissioner for Baltimore County

PETITON FOR ZONING VARIANCE 89-523-XA TO THE ZONING COMMISSIONER OF BALTIMORE COUNTY: CRITICAL AREA #392 The undersigned, legal owner(s) of the property situate in Baltimore County and which is described in the description and plat attached hereto and made a part hereof, her by petition for a Variance from Section 409.6.4.2. To permit a total of 22 off-street __parking apaces in lieu of the minimum 36 and 232.2.h to permit side _____ ___yard_setbacks_of_5!_[East]_and_6!_[West]_in_lieu_of_toe_minima-10!_----of the Zoning Regulations of Baltimore County, to the Zoning Law of Baltimore County; for the following reasons: (indicate hardship or practical difficulty) Building reasons: (indicate hardship or practical difficulty)

Building Already Exists And Because

OF THE SHAPE OF LOT HHE SETBACK'S AND

PANKING CHANOT BE MET. THE COMPREHENSIVE

PLANNER REZONED TO COMMERICA C. Property is to be posted and advertised as prescribed by Zoming Regulations. I, or we, agree to pay expenses of above Variance advertising, posting, etc., upon filing of this petition, and further agree to and are to be bound by the zoning regulations and restrictions of Baltimore County adopted pursuant to the Zoning Law For Baltimore County. I/We do solemnly declare and affirm under the penalties of perjury, that I/we are the legal owner(s) of the property which is the subject of this Petition. Contract Purchaser: (Type or Print Name) idaid C. (Type or Print Name) Address City and State Attorney for Petitioner: 3497 COCANUEU DRIVE. Address Phone No.


Onck MD. 21222

City and State (Type or Print Name) Name, address and phone number of legal owner, contract purchaser or representative to be contacted Attorney's Telephone No.: ORDERED By The Zoning Commissioner of Baltimore County, this _____ day //:_M.

Baltimore County Office of Planning & Zoning Towson, Marylar i 21204 (301) 887-3353

J. Robert Haines

Mr. Richard A. Jones 3492 Loganview Drive Baltimore, Maryland 21222

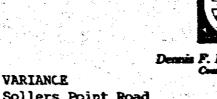

RE: PETITIONS FOR SPECIAL EXCEPTION AND ZONING VARIANCE NE/S Dundalk Avenue, 300' SE of the c/l of Sollers Point Road (7910 Dundalk Avenue) 12th Election District - 7th Councilmanic District Richard A. Jones - Petitioner Case No. 89-523-XA

Dear Mr. Jones:

Enclosed please find a copy of the decision rendered in the above-captioned r ter. The Petitions for Special Exception and Zoning Variance have been denied in accordance with the attached Order.

June 26, 1989

In the event any party finds the decision rendered is unfavorable, any party may file an appeal to the County Board of Appeals within thirty (30) days of the date of this Order. For further information on filing an appeal, please contact Ms. Charlotte Radcliffe at 494-3391.

Very truly yours,

J. Robert Haines Zoning Commissioner for Baltimore County

JRH:bjs

cc: Mr. Joseph Ewing Watersedge Improvement Association 8245 Peach Orchard Road, Baltimore, Md. 21222

People's Counsel

Chesapeake Bay Critical Areas Commission Tawes State Office Building, D-4, Annapolis, Md.

osted for: Spacial Excustion + Volion	Date of Posting 6/4/87
osted for Spacial Excustion + Volion	150
etitioner: Richard J. Junes	
2910 Dundool & Bry	300/ SE/SU/ 17.R4
7910 Dandool & Bry	
ocation of Signer Facing Dandoll Hro	**************************************

RE: PETITION FOR SPECIAL EXCEPTION : BEFORE THE ZONING COMMISSIONER

2 · 1 1 1 1 1 1 1

ENTRY OF APPEARANCE

Please enter the appearance of the People's Counsel in the above-

Phyllis Cole Friedman

Peter Max Zimmerman

Deputy People's Counsel

Towson, Maryland 21204

Room 304, County Office Building

People's Counsel for Baltimore County

captioned matter. Notices should be sent of any hearing dates or other

proceedings in this matter and of the passage of any preliminary or

I HEREBY CERTIFY that on this 23rd day of May, 1989, a copy

of the foregoing Entry of Appearance was mailed to Richard A. Jones,

3492 Loganview Drive, Dundalk, MD 21222, Petitioner

Case No. 89-523-XA

AND VARIANCE

final Order.

NE/S Dundalk Ave., 300' SE of

C/L of Sollers Pt. Rd. (7910

Dundalk Ave.), 12th Election Dist.; 7th Councilmanic Dist.

RICHARD A. JONES, Petitioner

Remarks: (Ports on Polls at Front & stone

The Zering Commissions:
Bellimore County by authority of
the Zoning Act and Regulation
of Bellimore County will hold a
public hearing on the property
identified herein in Room 106 of the County Office Building, to cated at 111 W. Chesapeate Av enue in Towson, Maryland 21200

Petitions for Special Exc.

tion and Zoning Verlance Case number: 89-523-XA NE/S Dundalk Avenue, 3 ft. Se of cf. of Sollers Po

Road
7910 Dundalit Avenue
12th Election District
7th Councilmanic
Petitionar(a):
Richard A. Jones
Hearing Date: Thursday,
June 22, 1909 at 11:00 sp.m.

east) and 6 ft. (west) in Sev of minimum 10 ft.

appeal period. The Zoring Conversioner will, however, entertain any request for a stay of the is

aumno of said permit during this period for good cause shows. Such request must be in writing and received in this office by the date of the hearing set above or

CERTIFICATE OF PUBLICATION

TOWSON, MD., June 2 . 1989 THIS IS TO CERTIFY, that the annexed advertisement was published in THE JEFFERSONIAN, a weekly newspaper published in Towson, Baltimore County, Md., once in each of ____ successive

89-503-XA

6/6/79

PO 12577 neg M30914 RS 89-523-XA price \$ 43.34

PETITION FOR SPECIAL EXCEPTION TO THE ZONING COMMISSIONER OF BALTIMORE COUNTY: 89-523-X The undersigned, legal owner(s) of the property situate in Baltimore County and which is described in the description and plat attached hereto and made a part hereof, hereby petition for a Special Exception under the Zoning Law and Zoning Regulations of Baltimore County, to use the SE SE herein described property for _____230.13 __ a_garage, service Property is to be posted and advertised as prescribed by Zoning Regulations. I, or we, agree to pay expenses of above Special Exception advertising, posting, etc., upon filing of this petition, and further agree to and are to be bound by the zoning regulations and restrictions of Baltimore County adopted pursuant to the Zoning Law for Baltimore County. I/We do solemnly declare and affirm, under the penalties of perjury, that I/we are the legal owner(s) of the property which is the subject of this Petition. Contract Purchaser: (Type or Print Name) (Type or Print Name) City and State Attorney for Petitioner: 3492668n WiEuCh. 282-4572 (Type or Print Name) K MD. 21222 Name, address and phone number of legal owner, contract purchaser or representative to be contacted City and State ORDERED By The Zoning Commissioner of Baltimore County, this ____

> required by the Zoning Law of Baltimore County, in two newspapers of general circulation throughout Baltimore County, that property be posted, and that the public hearing be had before the Zoning

> Commissioner of Baltimore County in Room 106, County Office Building in Towson, Baltimore

Z.C.O.-No. 1

Baltimore County
Zeeing Commissioner
Office of Pleaning & Zeeing
Toursen, Maryland 21204
887-3353

NOTICE OF NEARING

the property identified burein in Reem106 of the County Office Bubling, lucated at 111 W. Chesapashe Avenue
in Towers, Maryland as follower:
Putitions for Special Exception
and Zoning Verlages
CASE MUNISERS RESZENA
HERS Bundalls Avenue, 380 Yr. SE
of cf1 of Soliers Point Reed
7918 Dandalls Avenue

7918 Dundelk Avenus
7918 Dundelk Avenus
12th Election District
7th Councilessaic District
Putitioneris: Richard A. Jones
REARING SCHEDULED:

THURSDAY, JUNE 22, 1969 at 11:00 a.m. Special Exception: A garage, ser-

Variance: To permit a total of 22.

off-street parking spaces in lieu of the minimum 36 and to permit side yard probacks of 5 ft, losstly and 6 ft, (west in fees of the minimum, 10 ft.)
In the avenut that this Petition in

granted, a building permit may be in-send within the thirty (30) day appeal

period. The Zening Conversainmer will, however, entertain any request for a

stay of the issuance of said permit during this period for good cause

shows. Such request west be in writ-

ing and received in this office by the

date of the hearing sat above or pre-

-

I. Robert Haines!

CERTIFICATE OF PUBLICATION

Dundalk Eagle 4 N. Center Place P. O. Box 8936

Dundalk, Md. 21222

May 25,

THIS IS TO CERTIFY, that the annexed advertisement of Robert Haines in the matter of Zoning Hrgs. Case # -523-XA - P.O. #12576 - Req. #M30915 - 83 lines @ 1 was inserted in **The Dundalk Eagle** a weekly newspaper published in Baltimore County, Maryland, once a week ********* weeks before the 19 89; that is to say, the same was inserted in the issues of May 25, 1989

> Kimbel Publication, Inc. per Publisher.

CRITICAL AREA

DESCRIPTION TO ACCOMPANY

ZONING SPECIAL EXCEPTION AND VARIANCE

Beginning at a distance of approximately 300' easterly of intersection of Sollers Point Road and Dundalk Avenue on the north side of Dundalk Avenue are the following courses: 1) N 27^o 49' 43" E, 288.28 feet. 2) S 43^o 41' 61" E, 40.00 feet. 3) S 17° 15' 56" W. 4) R = 2044.00, L = 89.35' to the point of Also being known as 7910 Dundalk

Reclard Janes


CASE. NO 89-523-XA

WANTS TO ENTER AN APPEAC

TO J. ROBERT HAINES 6/30/89

> RICITED A. JONES 3492 LOGANNIEW PR. 55515 PM ..OTJAB

BALTIMORE COUNTY, MARYLAND Me n ones OFFICE OF FINANCE - REVENUE DIVISION MISCELLANEOUS CASH RECEIPT RUMERTON 6 30-87 AMOUNT \$ 205.00 RECEIVED RICHIED JONES CHARLES INVENT 6-30-89 (0.K. cm)
ZONING OFFICE MOTENT FUNCT CASE # 89- DIA B B 162 CARAGO 200 (CARAGO PARTIES OF CASHIER

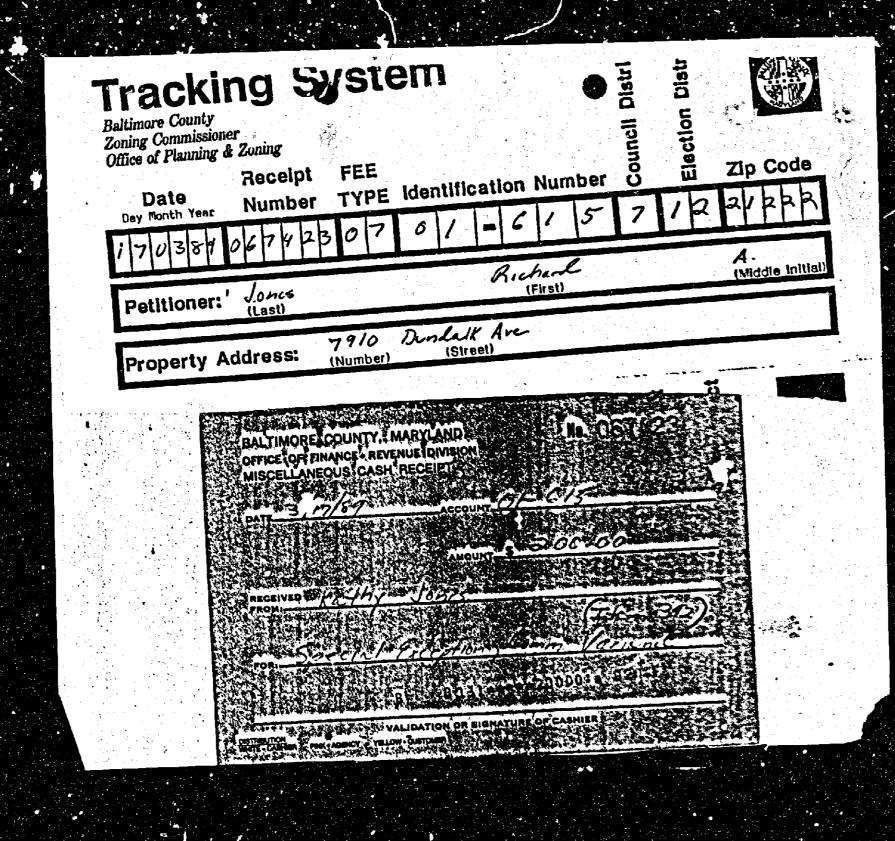

BALTIMORE COUNTY OFFICE OF PLANNING & ZONING

County Office Building 111 W. Chesapeake Avenue Towson, Maryland 21204

Your petition has been received and accepted for filing this 5번 day of April , 1989.

Petitioner First A. Jones Petitioner's Attorney

89-523-XA

Received by: <u>James E. Dyer</u> Chairman, Zoning Plans

Baltimore County
Zoning Commissioner
Office of Planning & Zoning Towson, Maryland 21204

Dennis F. Reconneces County Executive

Mr. Richard A. Jones 3492 Loganview Drive Dundalk, Maryland 21222

Re: Petitions for Special Exception and Zoning Variance

CASE NUMBER: 89-523-XA NE/S Dundalk Avenue, 300 ft. Se of c/1 of Sollers Point Road 7910 Dundalk Avenue

12th Election District - 7th Councilmanic Petitioner(s): Richard A. Jones HEARING SCHEDULED: THURSDAY, JUNE 22, 1989 at 11:00 a.m.

Dear Mr. Jones:

Please be advised that 114.84 is due for advertising and posting of the above-referenced property. All fees must be paid prior to the bearing. Do not remove the sign and post set(s) from the property from the time it is posted by this office until the day of the hearing itself.

THIS FEE MUST BE PAID AND THE ZONING SIGN(S) AND POST(S) RETURNED ON THE DAY OF THE HEARING OR THE ORDER SHALL NOT BE ISSUED.

Please make your check payable to Baltimore County, Maryland and bring it along with the sign(s) and post(s) to the Zoning Office, County Office Building, Room 111, Towson, Maryland 21204 fifteen (15) minutes before your hearing is scheduled to begin.

Please note that should you fail to return the sign and post set(s), there will be an additional \$25.00 added to the above fee for each set not

Very truly yours,

J. Robert Haines J. ROBERT HAINES Zoning Commissioner of Baltimore County

Baltimore County Zoning Commissioner
Office of Planning & Zoning Towson, Maryland 21204 494-3353

J. Robert Haines

NOTICE OF HEARING



The Zoning Commissioner of Baltimore County, by authority of the Zoning Act and Regulations of Baltimore County will hold a public hearing on the property identified herein in Room 106 of the County Office Building, located at 111 W. Chesapeake Avenue in Towson, Maryland as follows:

Petitions for Special Exception and Zoning Variance CASE NUMBER: 89-523-XA NE/S Dundalk Avenue, 300 ft. Se of c/l of Sollers Point Road 7910 Dundalk Avenue 12th Election District - 7th Councilmanic Petitioner(s): Richard A. Jones HEARING SCHEDULED: THURSDAY, JUNE 22, 1989 at 11:00 a.m.

Special Exceptions A garage, service. Variance: To permit a total of 22 off-street parking spaces in lieu of the minimum 36 and to permit side yard setbacks of 5 ft. (east) and 6 ft. (west) in lieu of the minimum 10

In the event that this Petition is granted, a building permit may be issued within the thirty (30) day appeal period. The Zoning Commissioner will, however, entertain any request for a stay of the issuance of said permit during this period for good cause shown. Such request must be in writing and received in this office by the date of the hearing set above or presented at the hearing. . Poly of Maire

J. ROBERT HAINES Zoning Commissioner of Baltimore County

cc: Richard A. Jones



Foom 301, County Office Bldg.

County Board of Appeals of Baltimore County

COUNTY OFFICE BUILDING 111 W. CHESAPEAKE AVENUE TOWSON, MARYLAND 21204 (301) 494(3180) 887-3180

September 27, 1989 NOTICE OF ASSIGNMENT

NO POSTPONEMENTS WILL BE GRANTED WITHOUT GOOD AND SUFFICIENT REASONS. REQUESTS FOR POSTPONEMENTS MUST BE IN WRITING AND IN STRICT COMPLIANCE WITH BOARD RULE 2(b). NO POSTPONEMENTS WILL BE GRANTED WITHIN FIFTEEN (15) DAYS OF SCHEDULED HEARIES DATE UNLESS IN FULL COMPLIANCE WITH RULE 2(c), COUNTY COUNCIL BILL NO. 59-79.

W. Carl Richards,/Jr.

Docket Clerk - Zoning

Arnold Jablon, Co aty Attorney

CASE NO. 89-523-XA RICHARD A. JONES, NE/s Dundalk Avenue, 300° SE of the c/l of Sollers Point Rd. (7910 Dundalk ave.) 12th Election District 7th Councilmanic District

> SE: Service Garage VAR: 22 parking spaces in lieu of 36; side yard settacks 6/26/89 - Z.C.'s Order DENYING Petitions

THURSDAY, FEBRUARY 15, 1990 at 10:00 a.m.

Appel/ant cc: Richard A. Jones Joseph Ewing (Watersedge Improvement Association) People's Counsel for Baltimore County P. David Fields Pat Keller J. Robert Haines Ann M. Nastarowicz James E. Dyer

LindaLee M. Kuszmaul Legal Secretary



County Office Building

Advisory Committee

County Board of Appeals of Baltimore County

COUNTY OFFICE BUILDING 111 W. CHESAPEAKE AVENUE TOWSON, MARYLAND 21204 (301) 494(3)80: 887-3180 January 18, 1990

NOTICE OF POSTPONEMENT AND REASSIGNMENT

NO POSTPONEMENTS WILL BE GRANTED WI HOUT GOOD AND SUFFICIENT REASONS. REQUESTS FOR POSTPONEMENTS MUST BE IN WRITING AND IN STRICT COMPLIANCE WITH BOARD RULE 2(b). NO POSTPONEMENTS WILL BE GRANTED WITHIN FIFTEEN (15) DAYS OF SCHEDULED HEARING DATE UNLESS IN FULL COMPLIANCE WITH RULE 2(c), COUNTY COUNCIL BILL NO. 59-79.

CASE NO. 89-523-XA

RICHARD A. JONES NE/s Dundalk Avenue, 300' SE of the c/l of Sollers Point Road (7910 Dundalk Avenue) 12th Election District; 7th Councilmanic District SE -Service Garage VAR -22 parking spaces in lieu of 36; side yard setbacks

6/26/89 -Z.C.'s Order DENYING Petitions.

THE REST OF STREET, ST

BALTIMORE CONTY, MARYLAND OFFICE OF FINANCE - REVEN'S DIVISION

MISCELLANEOUS CASH ...CLEIPT

6/22/89

M 3175

K-C1-615-000 -

100 KA for 6 22 / 69 Hoaring 89-523-XA

VALIDATION OR SIGNATURE OF CARRIER

B B E31 **** 11454: a 8725F

which had been scheduled for hearing on Thursday, February 15, 1990 has been POSTPONED at the request of Coursel for Appellant /Petitioner due to existing court conflict; and has been

TUESDAY MARCH 6, 1990 at 1:30 p.m.y

People's Counsel for Baltimore County

cc: Richard A. Jones S. Eric DiNenna, Esquire Mr. Joseph Ewing (Watersedge Imp. Assn.)

Counsel for Appellant /Petitioner Protestant

Appellant /Petitioner

P. David Fields Pat Keller J. Robert Haines

Ann M. Nastarowicz James E. Dyer W. Carl Richards, Jr. Docket Clerk -Zoning

Arnold Jablon, County Attorney

Kathleen C. Weidenhammer Administrative Assistant



County Board of Appeals of Baltimore County

COUNTY OFFICE BUILDING 111 W. CHESAPEAKE AVENUE TOWSON, MARYLAND 21204 (301) 494(3):80: 887-3180 January 18, 1990

NOTICE OF POSTPONEMENT AND REASSIGNMENT

NO POSTPONEMENTS WILL BE GRANTED WITHOUT GOOD AND SUFFICIENT REASONS. REQUESTS FOR POSTPONEMENTS MUST BE IN WRITING AND IN STRICT COMPLIANCE WITH BOARD RULE 2(b). NO POSTPONEMENTS WILL BE GRANTED WITHIN FIFTEEN (15) DAYS OF SCHEDULED BEARING DATE UNLESS IN FULL COMPLIANCE WITH RULE 2(c), COUNTY COUNCIL BILL NO. 59-79.

CASE NO. 89-523-XA

RICHARD A. JONES NE/s Dundalk Avenue, 300' SE of the c/l of Sollers Point Road (7910 Dundalk Avenue) 12th Election Disprict; 7th Councilmanic District SE -Service Garage

VAR -22 parking spaces in lieu of 36; side yard setbacks 6/26/89 -Z.Q.'s Order DENYING Petitions.

which had been scheduled for hearing on Thursday, February 15, 1990 has been POSTPONED at the request of Counse for Appellant /Petitioner due to existing court conflict; and has been

TUESDAY, MARCH 6, 1990 at 1:30 p.m. REASSIGNED FOR:

cc: Richard A. Jones S. Eric DiNenna, Esquire

Appellant /Petitioner Counsel for Appellant /Petitioner Mr. Joseph Ewing Protestant

(Watersedge Imp / Assn.) People's Counsel for Baltimore County P. David Fields Pat Keller

J. Robert Haines Ann M. Nastarowicz James E/Dyer W. Carl Richards, Jr.

Docket Clerk -Zoning Arnold Jablon, County Attorney

Kathleen C. Weidenhammer Administrative Assistant



County Board of Appeals of Baltimore County COUNTY OFFICE BUILDING, ROOM 315 111 W. CHESAPEAKE AVENUE

TOWSON, MARYLAND 21204

(301) 887-3180

GARRISON, MARYLAND

HEARING ROOM -Room 301, County Office Building

#89-486-A

APPEAL HEARINGS SCHEDULED FOR THE WEEK OF FEBRUARY 12, 1990

TUESDAY 2/13/90 10:00 (CASE NO. CBA-89-152 POSTPONED - NO RESET DATE)


TUESDAY 2/13/90 1:00 (CASE NO. CBA-89-153 POSTPONED - NO RESET DATE) WEDNESDAY 2/14/90 10:00 a.m. GARRISON VALLEY CENTER, INC. 9600 REISTERSTOWN ROAD

#CBA-89-154

RE: Denial of Trailer Permit MARY E. HALL, NE/s Hilldale Rd., WEDNESDAY 2/14/90 1:00 p.m. 160' NW of c/1 Old Philadelphia Rd. (1200 Hilldale Rd.) 15th Election District 7th Councilmanic District

VAR -Height of satellite dish THURSDAY 2/15/90 10:00 (CASE NO. 89-523-XAL POSTPONED TO 3/6/90) FRIDAY 2/16/90 HEARING ROOM NOT AVAILABLE FOR CBA HEARING

cc: Executive Office County Council Law Office People's Counsel Planning Office Current Planning Board Members Court Reporter Information Desks (2) √Docket Clerk -Zoning

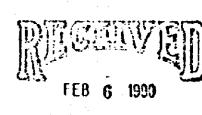

ZONING OFFICE



County Moard of Appeals of Baltimore County

COUNTY OFFICE BUILDING 111 W. CHESAPEAKE AVENUE TOWSON, MARYLAND 21204 (301) 494-5120 887-3180

HEARING ROOM -

Room 301, County Office Puilding

March 5, 1990 NOTICE OF POSTPONEMENT AND REASSIGNMENT

NO POSTFONEMENTS WILL BE GRANTED WITHOUT GOOD AND SUFFICIENT REASONS. REQUESTS FOR POSTPONDENTS MUST BE IN WRITING AND IN STRICT COMPLIANCE WITH BOARD BULE 2(b). NO POSTPONEMENTS WILL BE GRANTED WITHIN FIFTEEN (15) DAYS OF SCHEDULED HEARING DATE UNLESS IN FULL COMPLIANCE WITH BULE 2(c), COUNTY COUNCIL BILL NO. 59-79.

CASE NO. 89-523-XA

RICHAFD A. JONES NE/s Dundalk ireque, 300' SE of the c/l of Sollers Point Road (7910 Dundalk Avenue) 12th Election District; 7th Cou : Imanic District

SE -Service Sarage VAR -22 parking spaces in lieu of 36; side yard setbacks

6/26/89 -I.C.'s Order which DENIED Petitions

which had been assigned for hearing on Tuesday, March 6, 1990 was POSTPONED ON THE RECORD and reassigned to Friday, June 15, 1990; no further postponements to be granted except in extraordinary circumstances; and has been

REASSIGNED FOR:

FRIDAY, JUNE 15 1000 at 11:00 a.m.

cc: S. Eric DiNenna, Esquire Richard A. Jones

Counsel for Appellant /Petitioner Appellant SPetitioner

Fratestert Mr. Joseph Ewing (Watersedge Improvement Assn.) People's Counsel for Baltimore County Project Fued war

P. David Fields

Pat Keller J. Robert Haines

Ann M. Nastarowicz

James E. Dyer

W. Carl Richards, Jr. Docket Clerk -Zoning

Arnold Jablon, County Attorney

Tathleen C. Weidenhammer Ms. Sharon Gard <u>Imministrative</u> Assistant BALTI MORE COUNTY ZONING PLANS ADVISORY COMMITTEE

June 7, 1989

COUNTY OFFSCE BLOG. 111 W. Chemapeake Ave. Towson, Haryland 21204

Mr. Richard A. Jones 3492 Loganview Drive Dundalk, MD 21222

RE: Item No. 392, Case No. 89-523-XA Petitioner: Richard A. Jones Petition for Zoning Variance and Special Exception

Burras of Department of Traffic Engineering

-NEMBERS

Bureau of Fire Prevention Health Department Project Planning

Building Department

Board of Education

Industrial Development

Zoning Administration

Dear Mr. Jones:

The Zoning Plans Advisory Committee has reviewed the plans submitted with the above referenced petition. The following comments are not intended to indicate the appropriate es of the zoning action requested, but to assure that all parties are made / are of plans or problems with regard to the development plans that may have a bearing on this case. Director of Planning may file a written report with the Zoning Commissioner with recommendations as to the suitability of the requested zoning.

Enclosed are all comments submitted from the members of the Committee at this time that offer or request information on your petition. If similar comments from the remaining members are received, I will forward them to you. Otherwise, any comment that is not informative will be placed in the hearing file. This petition was accepted for filing on the date of the enclosed filing certificate and a hearing scheduled accordingly.

IT WOULD BE APPRECIATED IF YOU WOULD RETURN YOUR WEITTEN COMMENTS TO MY OFFICE, ATTENTION JULIE WINIARSKI. IF YOU EAVE ANY QUESTIONS REGARDING THIS, PLEASE CONTACT HER AT 887-1391.

Very truly yours.

Zoning Plans Ldvisory Committee

Enclosures

JED: jw

BALTIMORE COUNTY, HARYLAM

INTER-OFFICE CORRESPONDENCE

FROM: Mr. Robert W. Sheesley

Zoning Commissioner

TO: Mr. J. Robert Haines

SUBJECT: Petition for Zoning Variance - Ties 3392 Richard Jones Property

SITE LOCATION

The subject property is located at 7910 - 7916 Dundalk Avenue in Dundalk. The site is within the Chesapeake Bay Critical Area and is classified as an Intensely Developed Area (IDA).

APPLICANT PROPOSAL

The site consists of an existing 8,000+ square foot building on a 11,700 square foot lot. The front portion of the building is zoned commercial and is currently in use as a liquor and grocery store. The rear portion of the building is zoned residential and is vacant.

The applicant proposes rezoning the rear portion of the building to commercial zoning and using it as a service garage.

The applicant has requested a Zoning Variance from Section 409.6.A.2. of the 1981 Baltimore County Zoning Regulations, "To permit a total of 22 off-street parking spaces in lieu of the minimum 36; Section 232.2.b. to permit side yard setbacks of 5' (East) and 6' (West) in lies: of the minimum 10'; and Section 230.13 to permit a service garage".

GOALS OF THE CHESAPEAKE BAY CRITICAL AREA PROGRAM

In accordance with the Chesapeake Bay Critical Area Program, all project approvals shall be based on a findings which assures that proposed projects are consistent with the following goals of the Critical Area Law:

1. "Minimize adverse impacts on water quality that result from pollutants that are discharged from structures or conveyances or that have runoff from surrounding lands;

2. Conserve fish, wildlife and plant habitat; and

Mr. J. Robert Haines May 9, 1989

Page 2

Establish land use policies for development in the Chesapeake Bay Critical Area which accommodate growth and also address the fact that even if pollution is controlled, the number. movement, and activities of persons in that area can create adverse environmental impacts. (COMAR 14.15.10.01.0)

REQUIREMENTS AND FINDINGS

Regulation: "New development and redevelopment within the IDA shall use Best Management Practices or other technology which reduces pollutant loading by 10% of the on-site level prior to new development or redevelopment. * <Balto. Co. Code Sec. 22-21?>

"Development means the construction or substantial alteration of residential, commercial, industrial, institutional, or transportation facilities or structures" <COMAR 14.15.01.01 (21)>.

"Redevelopment means the process of developing land which is or has been developed" <COMAR 14.15.01.01 (57)>.

Finding: The applicant's proposal to change the existing zoning from residential to commercial represents a "substantial alteration" of the land use permitted on the property and therefore is considered development in accordance with the above definition.

New development and redevelopment within IDA's shall reduce pollutant loadings by 10% of the on-site level prior to new development or redevelopment.

Conclusion: The above finding indicates that this request for a zoning variance cannot be approved until the applicant submits data complying with the 10% pollutant removal regulation.

Please contact Mr. David C. Flowers at 887-3980 if you require additional information.

> Robert W. Sheesley, Director Department of Environmental Protection and Resource Management

RWS: KLC: ju Attachment

cc: The Honorable Ronald B. Hickernell The Honorable Norman R. Lauenstein The Honorable Dale T. Volz

Baltimore County Fire Department Towson, Maryland 21204-2586 494-4500 Paul H. Reincke

Office of Planning and Zoning Baltimore County Office Building

J. Robert Haines Zoning Commissioner

Towson, MD 21204

Item No.: 392

Re: Property Owner: Richard A. Jones

Location: NE/S of Dundalk Ave, 300' SE of centerline of Sollers Point Road

Zoning Agenda: April 4, 1989

Pursuant to your request, the referenced property has been surveyed by this Bureau and the comments below marked with an "X" are applicable and required to be corrected or incorporated into the final plans for the property.

() 1. Fire hydrants for the referenced property are required and stall be located at intervals or ___ feet along an approved road in accordance with Baltimore County Standards as published by the Department of Public Works.

() 2. A second means of vehicle access is required for the site.

() 3. The vehicle dead end condition shown at

EXCEEDS the maximum allowed by the Fire Department. () 4. The site shall be made to comply with all applicable parts of the

Fire Prevention Code prior to occupancy or beginning of operation. (X) 5. The buildings and structures existing or proposed on the site shall comply with all applicable requirements of the National Fire Protection issociation Standard No. 101 "Life Safety Code," 1976 edition prior to occupancy.

() 6. Site plans are approved, as drawn.

() 7. The Fire Prevention Bureau has no comments at this time.

Playhing Group Special Inspection Division

BALTIMORE COUNTY, MARYLAND
INTEROFFICE CORRESPONDENCE

TO: Zoning Advisory Committee DATE: May 17, 1989 FROM: Robert W. Bowling, P.E.

Zoning Advisory Committee Meeting for April 4, 1989

The Developers Engineering Division has reviewed the zoning items for the subject meeting and we have no comments for Items 274, 359, 383, 389, 392/ 393, 394, 395, 396, and 398. Comments are attached for Items 384 and

> OBERT W. BOWLING, P.E., Chief Developers Engineering Division

RWB:s Encls.

BALTIMORE COUNTY, MARYLAND INTER-OFFICE CORRESPONDENCE

TO: J. Robert Haines DATE: June 21, 1989 Zoning Commissioner FROM: Pat Keller, Deputy Director

Office of Planning and Zoning SUBJECT: ZONING ADVISORY COMMITTEE COMMENTS

Case No. 89-523-XA 'Item No. 392

AND WAY

Re: Richard Jones

The Petitioner requests a special exception for a service garage and variances to allow 22 parking spaces in lieu of the required 36 spaces and side yard setbacks for an existing building. In reference to these requests staff offers the following comments:

The granting of the proposal with normal restrictions as determined by the Zoning Commissioner would not negatively impact the

A landscape plan must be approved prior to the issuance of any building permit. A note should be included on the plan indicating that any landscaping provided in the public right of way shall be maintained by the property owner.

A:62189.txt Pg.3

Baltimore County Department of Public Works Bureau of Traffic Engineering Courts Building, Suite 405 Towson, Maryland 21204 (301) 887-3554

April 25, 1989

Item: 392 Property Owner: Location:

Existing Zoning:

Proposed Zoning:

Mr. J. Robert Haines

County Office Building Towson, Maryland 21204

Zoning Commissioner

Richard A. Jones B.L.-C.N.S.

NE/S of Dundalk Avenue, 300' S.E. of centerline of Sollers Point Road. Special Exception for a garage service. Variance to permit a total of 22 off-street parking spaces in lieu of the minimum 36 and to permit side yard set backs of 5' (east) and 6' (west) in lieu of the minimum 10'.

District:

.409 acre 12th Election District

2.A.C. April 4, 1989

The requested variance to parking can be expected to cause parking problems in the area.

> Very truly yours, Michael S. Flanigan Traffic Engineer Associate II

APR 28 1989 ZONING OFFICE

Baltimore County Zoning Commissione Office of Planning & Zoning Towson, Maryla 1 21204 (301) 887-3353 J. Robert Haines
Zoning Commissioner

August 7, 1989

Baltimore County Board of Appeals County Office Building, Room 315 Towson, Maryland 21204

RE: Petition for Special Exception and Zoning Variance NE/S Dundalk Avenue, 300' SE of the c/1 of Sollers Point Road (7910 Dundalk Avenue) 12th Election District, 7th Councilmanic District RICHARD A. JONES - Petitioner Case No. 89-523-XA

Dear Board:

Please be advised that an appeal of the above-referenced case was filed in this office on June 30, 1989 by Richard A. Jones, Petitioser. All materials relative to the case are being forwarded herewith.

Please notify all parties to the case of the date and time of the appeal hearing when it has been scheduled. If you have any questions concerning this matter, please do not hesitate to contact this office.

JRH:cer

Enclosures

cc: Richard A. Jones, 3492 Loganview Drive, Balto., MD 21222 Joseph Ewing (Watersedge Improvement Association) 8245 Peach Orchard Road, Balto., MD 21222

People's Counsel of Baltimore County Rm. 304, County Office Bldg., Towson, Md. 21204

9/27/89 - Following parties notified of hearing set for February 15, 1990 at 10:00 a.m.:

Richard A. Jones Joseph Ewing People's Counsel for Baltimore County P. David Fields Pat Keller J. Robert Haines Ann M. Nastarowicz James E. Dyer W. Carl Richards. Jr. Docket Clerk - Zoning Arnold Jablon

1/18/90 -Request for Postponement filed by S. Eric DiNenna on behalf of Appellant / Petitioner; entry of appearance as Counsel for Appellant /Petitioner. Postponement GRANTED; Notice of Postponement and Reassignment sent this date to above and S. Eric DiNenna reassigning hearing date to Tuesday, March 6, 1990 at 1:30 p.m.

3/06/90 -Postponed on the record to agreed upon date of June 15, 1990 at 11:03 a.m.; no further postponements to be granted except in extraordinary circumstances. Notice of PP and Reassignment sent to above parties re hearing reassigned to (also to Sharon Gard) Friday, June 15, 1990 at 11:00 a.m.

Baltimore County Department of Recreation & Parks 301 Washington Avenue Towson, Ma. yland 21204 (301) 837-3817 (301) 887-5319 (Deaf/TDD) Robert R. Stanb



June 6, 1990

Richard A. Jones c/o W. Duvall & Associates, Inc. 530 E. Joppa Road Towson, Maryland 21204

Dear Mr. Jones:

The Baltimore County Department of Recreation and Parks authorizes you and your agents to install plantings on the Baltimore County owned park as per your submitted documents as required by Forrest Establishment guidelines.

You or your agents are also granted access to the park as needed to complete any needed maintenance of the plantings.

Sincerely,

neil (moques

Neil C. Magness, Program Coordinator Baltimore County Department of Recreation and Parks

NCM:pad

cc: Tammy Hinkle Jerry Crowell William Spells





Comity Board of Appeals of Baltime Comity

sanitary sewer via cit separation

COUNTY OFFICE BUILDING, ROOM 315 111 W. CHESAPEAKE AVENUE TOWSON, MARYLAND 21204 (301) 887-3180

July 24, 1990

-S. Eric DiNenna, Esquire DINENNA, MANN & BRESCHI P.O. Box 10508 Towson, MD 21285-0508

> RE: Case No. 89-523-XA Richard A. Jones, et at

Dear Mr. DiNenna:

On July 16, 1990, the exhibits in the subject case were inadvertently returned to you via correspondence which indicated that this case has been closed by the Board.

This letter is to advise you that the 30-day appeal period in this matter runs through July 26, 1990. At that time, should no appeal te taken from the Board's decision, we will then close the file. The exhibits forwarded to you need not be returned at this time, but those exhibits would be needed by this office should an appeal be taken.

Should you have any questions, please call me at 667-3182.

Sincerely, Kathleen C. Weidenhammer Administrative Assistant

cc: Mr. and Mrs. Richard A. Jones

Baltimore County Zoning Commissioner Office of Planning & Zoning Towson, Maryland 21204 (301) 887-3353 J. Robert Haines

November 1, 1990



7910 Dundalk Avenue #C Baltimore, Maryland 21222 H 212-9343 W) 27 -7108, 288-1750 Dear Mr. Mutlu:

We are holding your application for processing a zoning verification from the Motor Vehicle Administration for a wholesale dealers license.

The site in question, Dundalk Avenue Service Garage, 7910 Dundalk Avenue #C, Watersedge, Baltimore, was subject of a zoning hearing (special exception and variance) Case #89-523-XA. The Zoning Commissioner's decision was appealed to the County Board of Appeals who granted the request with four conditions.

I suggest you speak to the owner/applicant, Mr. Richard A. Jones. Proof of the compliance to conditions 1 thru 3 must be submitted to the Zoning Office Development Control Division before the issuance of any permits or approvals.

- A revised site plan eliminating proposed earth dike and stone outlet structure, showing proposed location and type of additional
- 2) copy of signed Forest Establishment Agreement; and
- 3) letter from Baltimore County Department of Recreation and Parks giving permission for use of the property to plant trees.

Very truly yours, Kluvence () Hoer. Laurence J. Goetz

cc: Richard Jones, 3492 Logan View Drive, Baltimore, Md. 21222 David Flowers, DEPRM, Critical Areas 89-523A

DINENNA, MANN & BRESCHI ATTORNEYS AT LAW

\$. ERIC DINENNA, P.A. JAMES L. MANN, JR., P.A. GEORGE A. BRESCHI, P.A. GERALDINE A. KLAUBER FRANCIS X. BORGERDING

SLETE 640 MERCANTRE FOR SON IR LONG 400 ENSUNCTON MENCE TOTSON, MAEYLAND 22304

(301) 296-6639 TELEME (301) 294-6484

January 16, 1990

County Board of Appeals County Office Building Towson, Maryland 21204

> RE: My File No.: 90-5 Petitioner: Richard Jones

Dear Mr. Chairman:

This is to confirm my conversation with your office wherein the above captioned matter has been postponed from February 15, 1990 to March 6, 1990 at 1:30 p.m..

appearance.

This is to formally advise you that I represent the Petitioners in this matter.

My request for this postponement is because of a prior court

Thank you for your cooperation.

cc: Mr. and Mrs. Richard Jones

SO 384 18 FILE: 15 CCANIA EGY SO CONTRACTOR OF SECURITY DINENNA, MANN & BRESCHI ATTORNEYS AT LAW

S. ERIC DINENNA, P.A. JAMES L. MANN, JR., P.A. GEORGE A. BRESCHE, P.A. GERALDINE A. KLAUBER

FRANCIS X. BORGERDING, JR.

MERCANTILE TOWSON BUILDING 409 WASHINGTON AVENUE TOWSON, MARYLAND 21204 (301) 296-6820 TELEFAX (301) 296-6884

SUITE 600

May 18, 1990

4th Floor, County Courts Building Towson, Maryland 21204

ATTN: Mr. David Flowers

RE: My Client: Richard Jones Special Exception & Variance Request

Case No.: 89-523-XA

Dear Mr. Plovers:

Pursuant to our conversation and the conversations in the continuance of the matter by the Board of Appeals, enclosed herewith please find the appropriate information and plats for your approval in accordance with the Chesapeake Bay Critical Area Legislation.

As you might be aware, this matter is set before the County Board of Appeals on Friday, June 15, 1990.

I would respectfully request that you study same and advise me in writing of your office's position in this matter.

As you are aware, a Special Exception or Variance can be granted by the zoning authorities for Baltimore County without your office's approval. Also, the County Board of Appeals must make its findings.

I appreciate your cooperation and help in this matter.

Very truly yours,

S. ERIC DINENNA

SED:cjc Enclosure cc: County Board of Appeals Phyllis Friedman, People's Counsel Mr. and Mrs. Richard Jones

Mr. Norman Gerber

90 MAY 21 AM 11: 49 COUNTY BOARD OF APPEALS

COUNTY BOARD OF APPEALS FOREST ESTABLISHMENT PLAN AND AGREEMENT

Richard A. Jones
3492 Loganwew Drive
Baltimore, MD 21222
282-4572

Location of Development

Dundalk Avenue Service Garage Baltimore County, Maryland


For compliance with the 10% rule in IDA



Prepared by

H. Christoph Stuhlinger Bay Watershed Forester


July 24, 1990

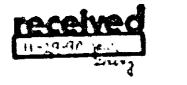



DUNDALK
AVENUE
SERVICE
GARAGE


Revised 6-4-90

DUNDALK AVENUE SERVICE GARAGE

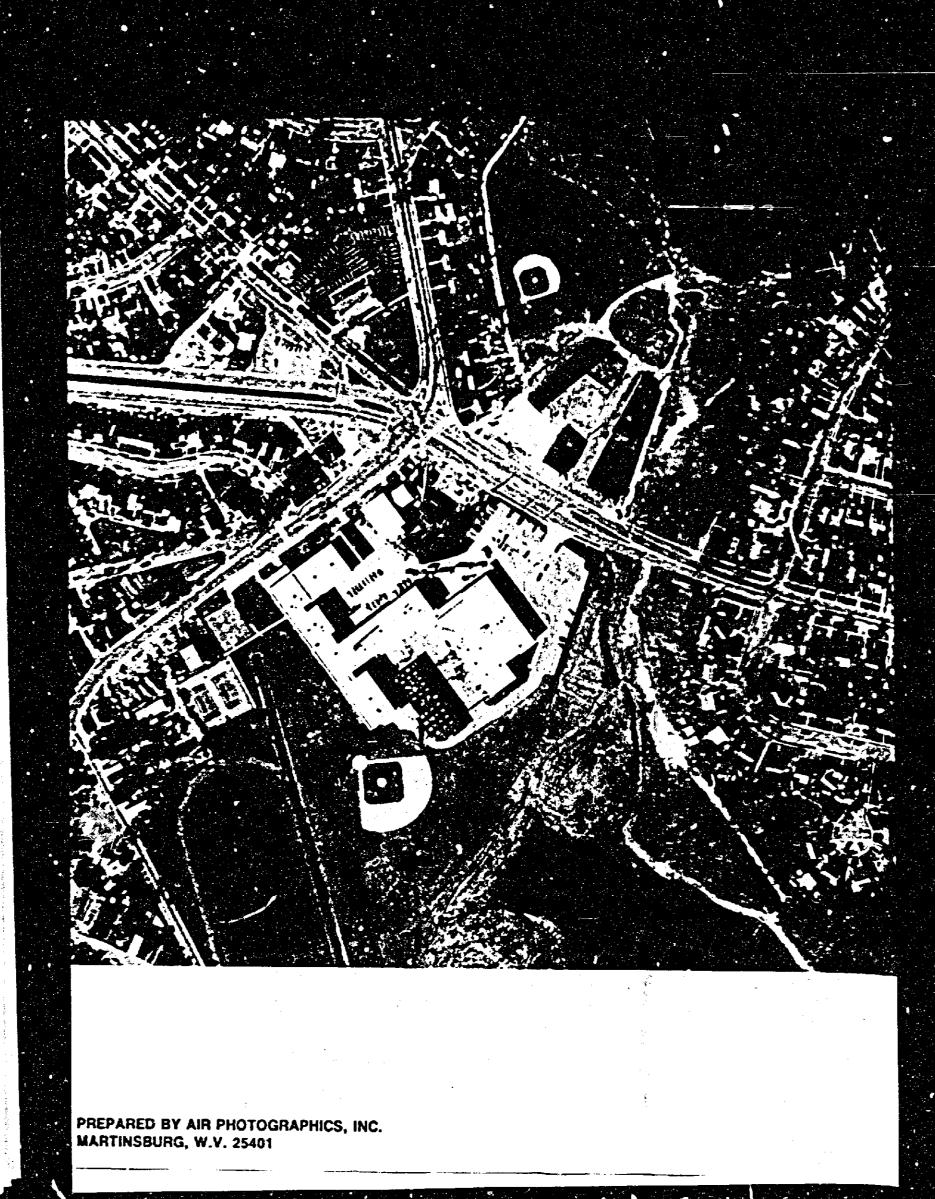

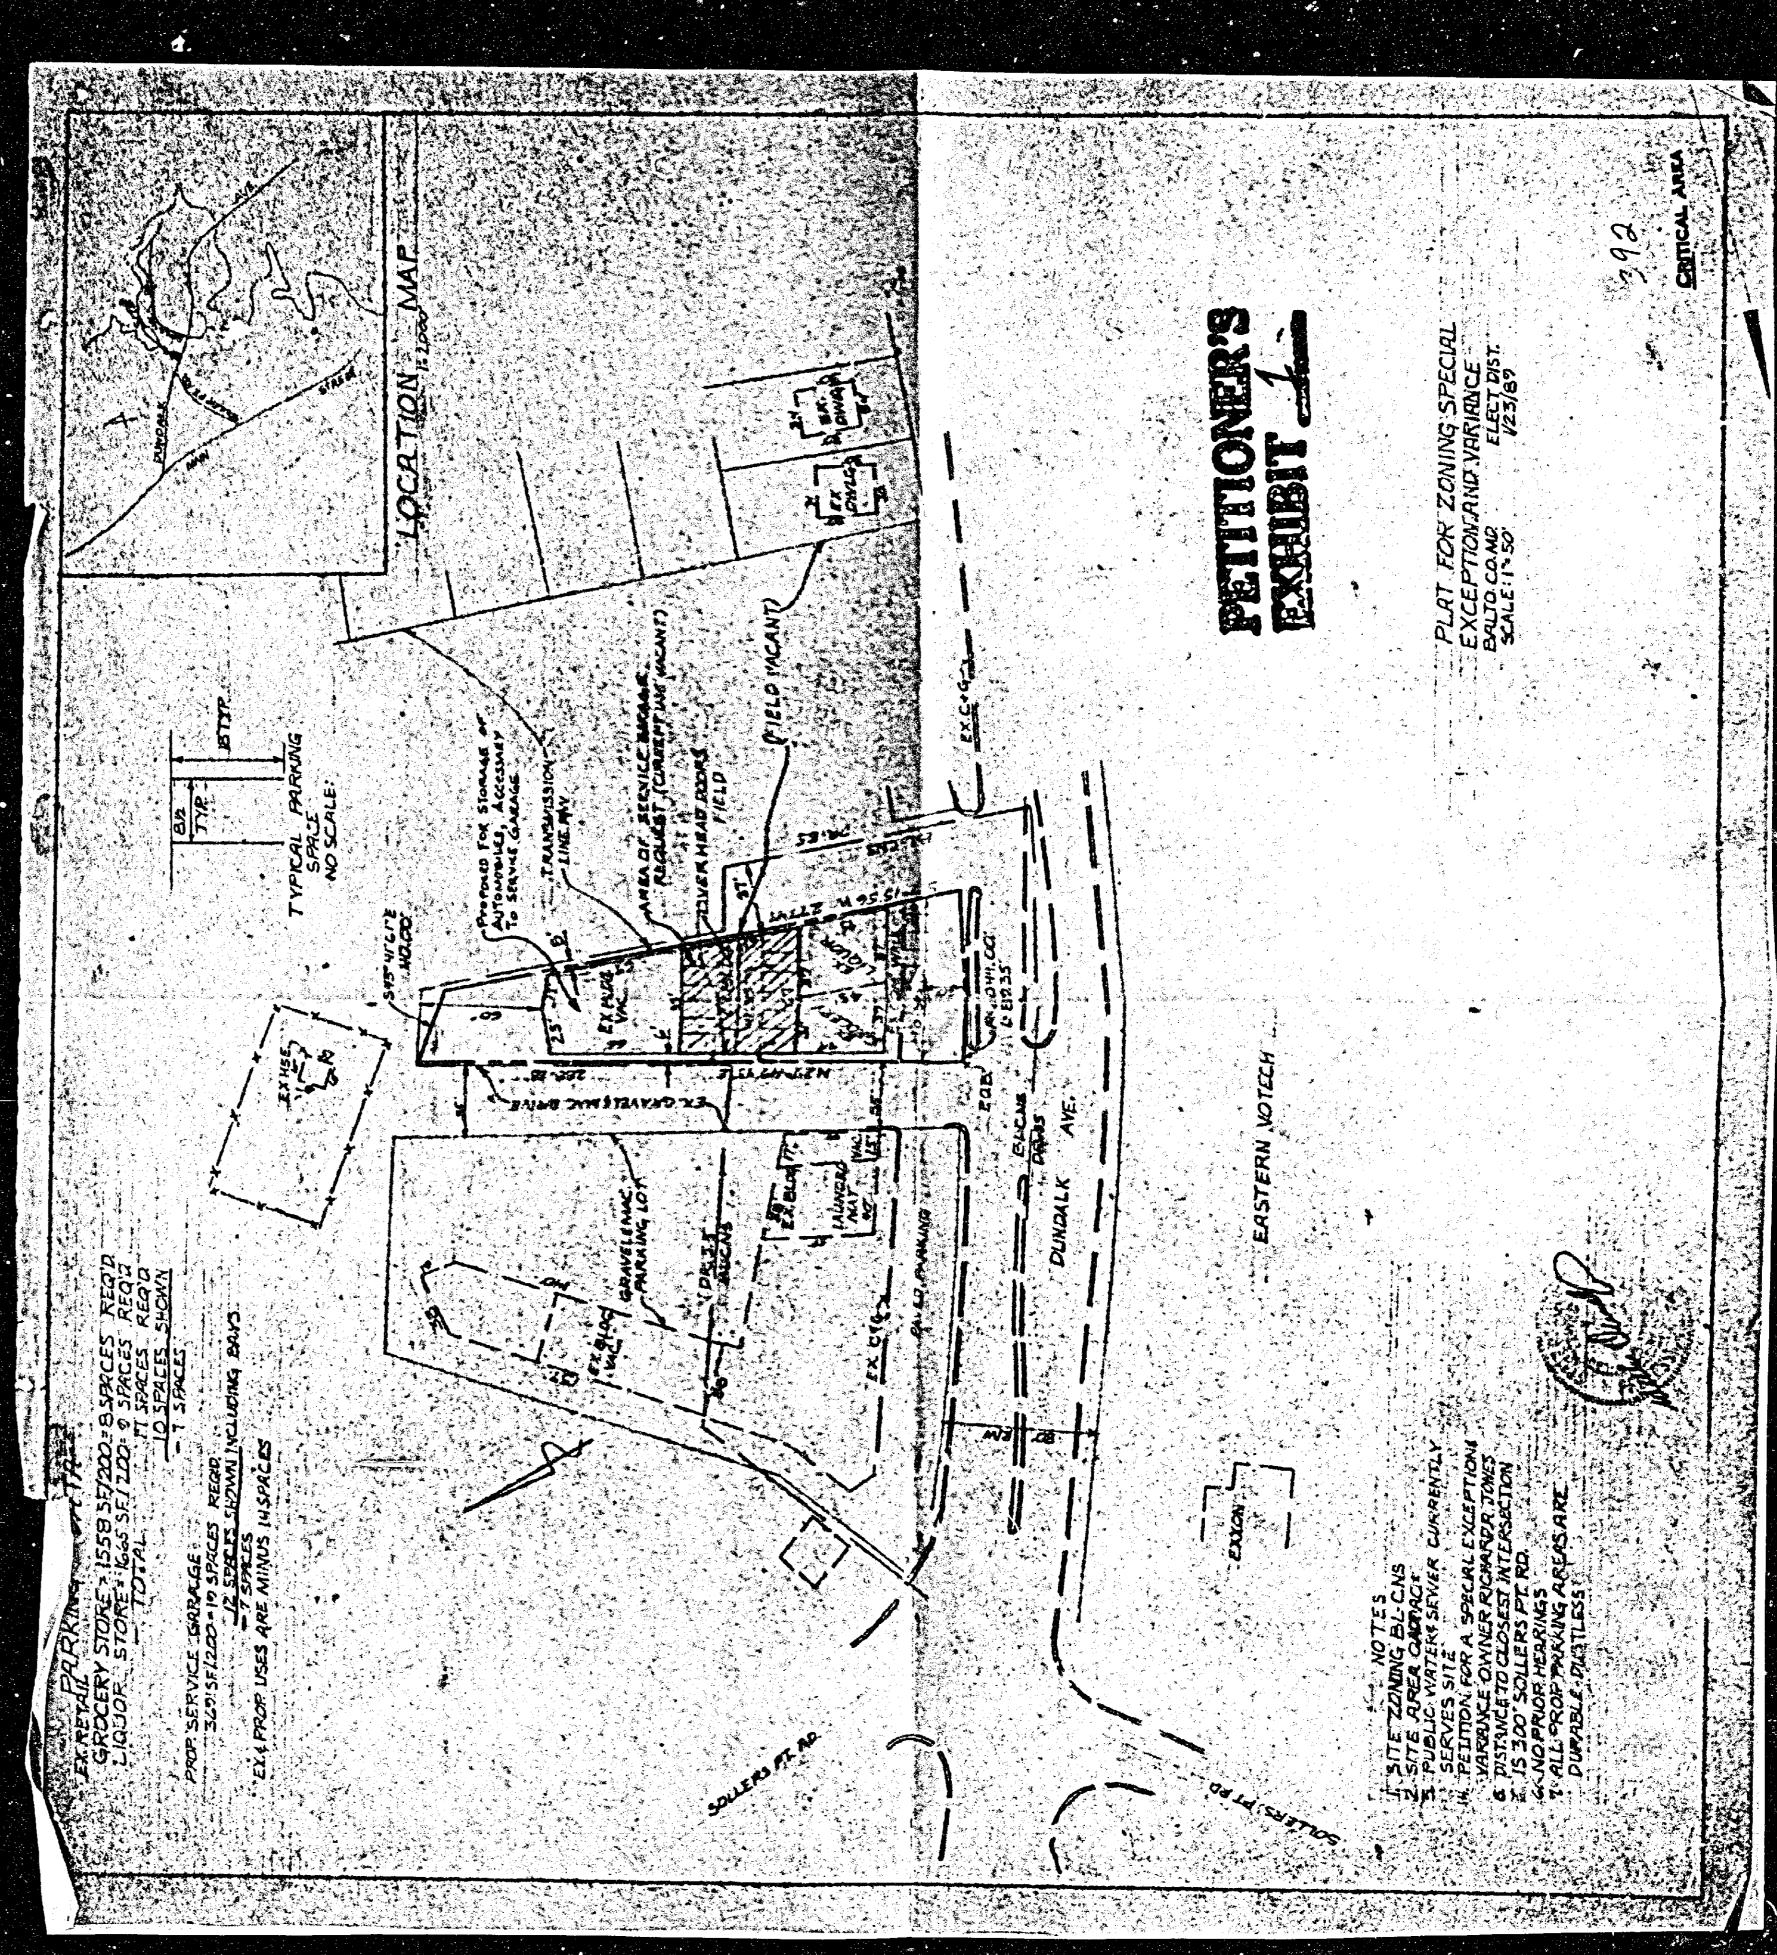

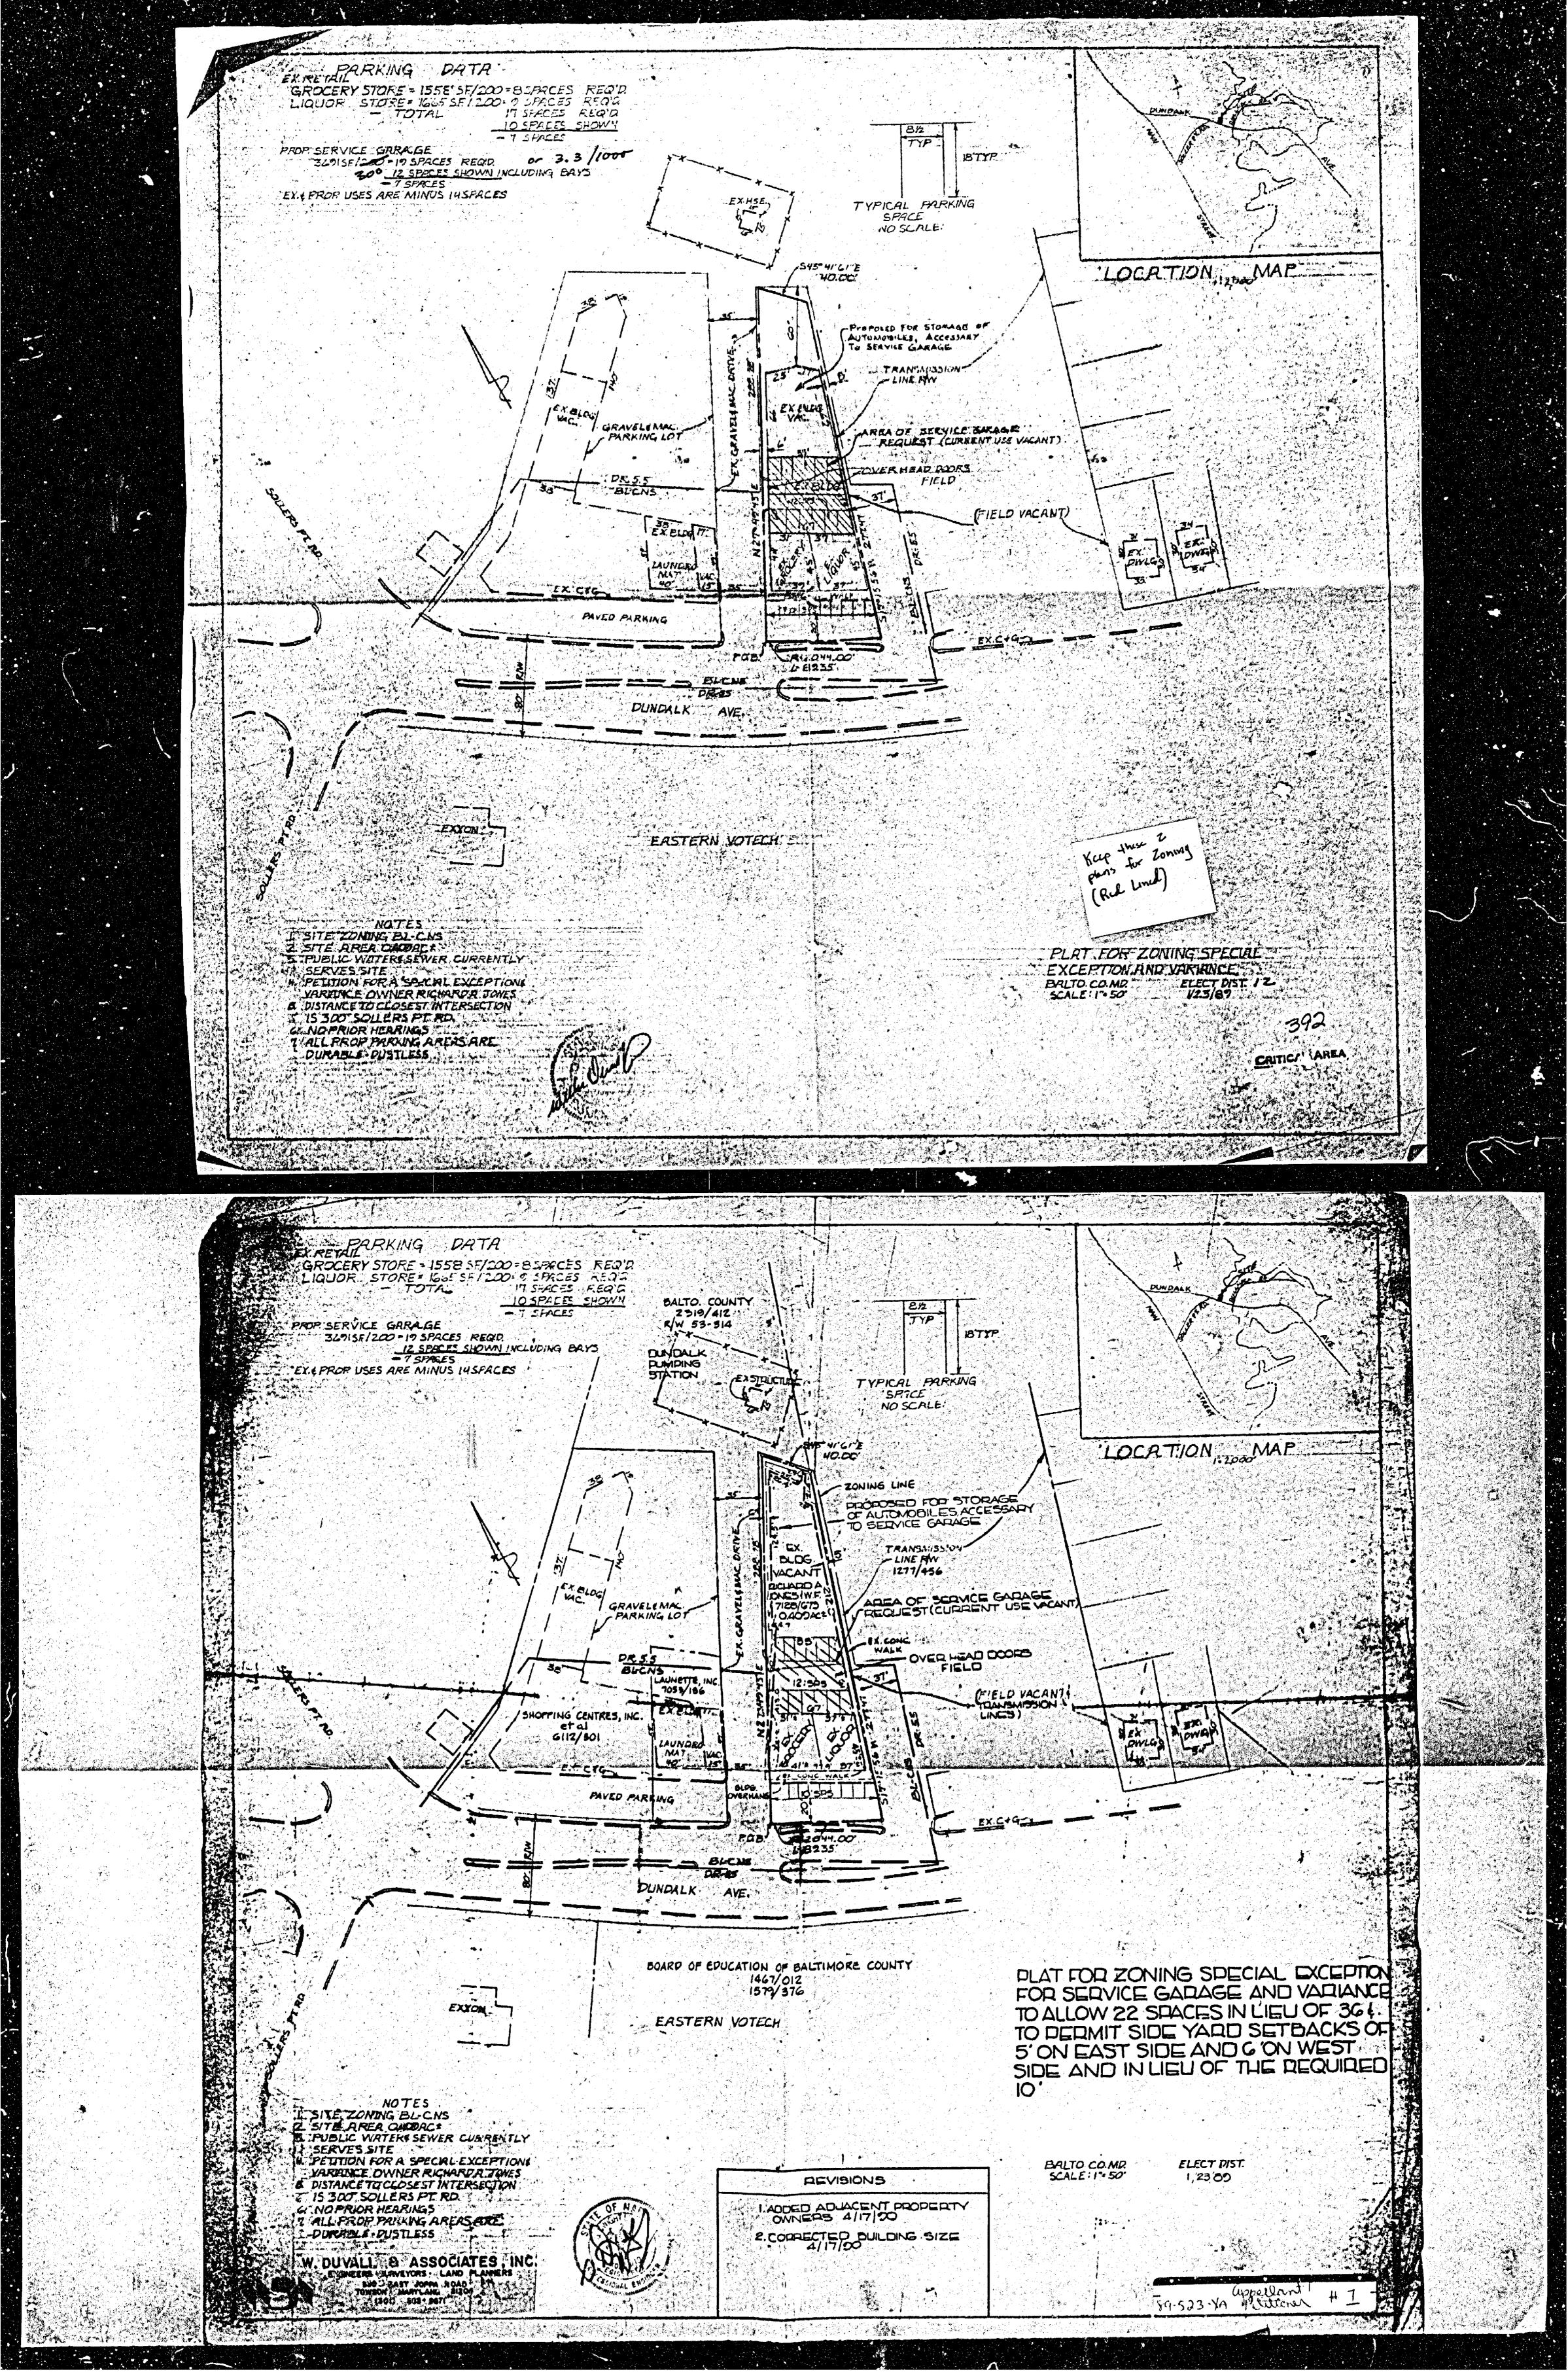


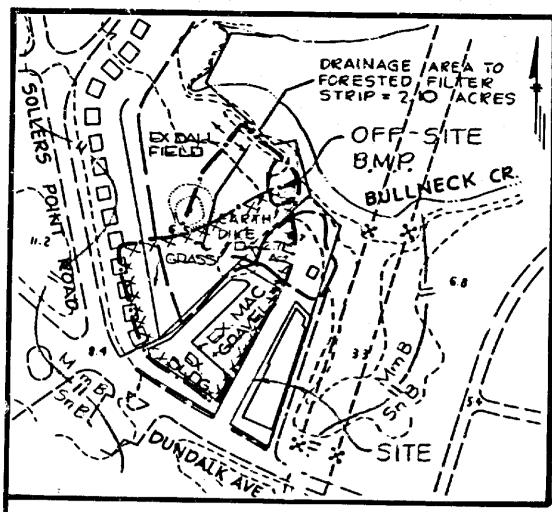


DRAINAGE AREA MAP

SCALE: I" = 200'

NOTE: ALL WIRE INON BIODEGRADABLE PLASTIC BALL TIES SHALL DE RE-MOVED.

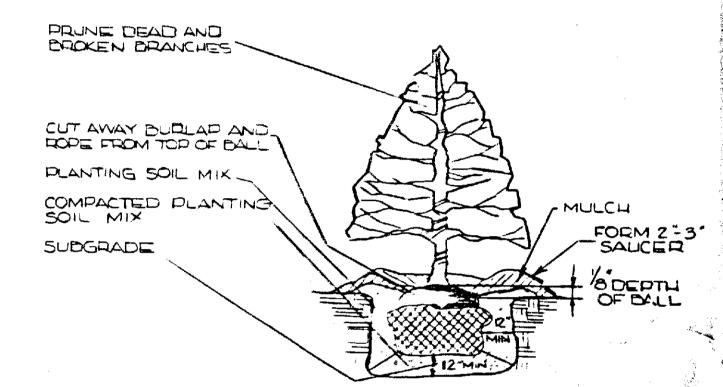

SURUB AND TREE PLANTING

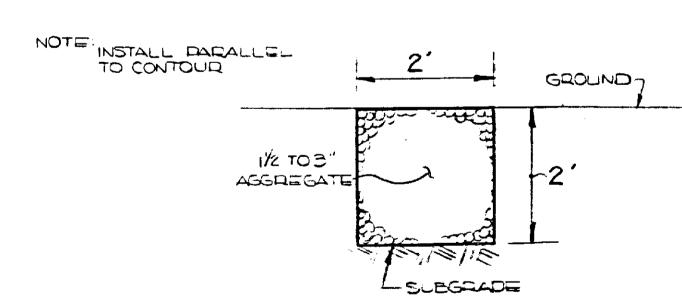

LEVEL SPREADER

LEVEL SDREADER

EARTH DIKE

Plant Material - All nursery stock shall be planted in accordance with the American Association of Nurserymen, Inc. "American Standards for Nursery Stock, " latest edition,

Plant Types - Plant types have been selected from the Bottomland Moist Association contained in Resolution 14-88. Any change in quantity, spacing and location of plants may require D.E.P.R.M. approval.


Mulching - All trees and shrubs shall be mulched a minimum of 18" beyond the edge of the root ball. All shrub masses shall be planted in continuous mulch

- 2. The proposed forested filter strip was designed based on The Chesapeake Bay Critical Area Commission and the Maryland Department of the Environment Framework for Evaluating Compliance with the 10% Rule in the Chesapeake Bay Critical Area, Suidance Paper No. 5.
- 3. The proposed plantings are in accordance with County Council of Baltimore County, Maryland Resolution 14-88.
- 4. Topography shown hereon is taken from Baltimore County 200 Scale Topography Sheet S.E. 5-F.
- 5. Property lines shown hereon were taken from deeds and record plats.
- 6. Prior to commencing construction, property lines and existing fences are to be established in the field as necessary.

GRASS L=GxDA - Gx2.71 - IG.3 DALTO.CO.MD. 2023/504 -D 13:22 BALTO CO. MD 2319/412 DLAN SCALE: 1=20'

OWNED/DEVELOPED

RICHARD A. JONES 3492 LOGANVIEW DRIVE BALTIMORE, MADYLAND 21222

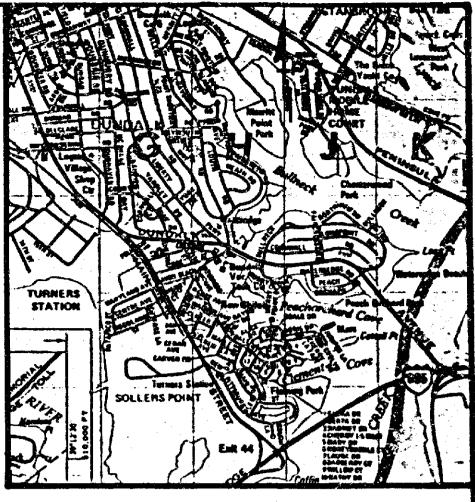

SCALE: 1" = 2000'

TREE LIS	I			
Symbol	Quantity	Botanical Name/ Common Name	Size and Condition	Spacing
\otimes	3	Acer rubrum/ Red Haple	1"- 1 1/2" Cal. B. & B.	8. o.c.
①	2	Betula nigra/ River Birch	1"- 1 1/2" Cal. B. & B.	8. o.c.
Θ	2	Carya tementosa/ Mockernut Hickory	Bare Root Seedling	8' 0.c.
③	2	Nyssa sylvatica/ Black Gum	Whip B. & B.	9' o.c.
O	. 3	Clatanus occidentalis/ Sycamore	Barm Root Smedling	8' o.c.
8	2	Quercus alba/ White Dak	Whip B. & B.	8° c.c.
\odot	5	Quercus palustris/ Pin Oak	Whip B. & B.	B' o.c.
TOTAL	17			

•		Common Name	and Condition	
⊙ <u>.</u>	. 	Clethra alnifolia/ Sweet Pepperbush	12"-18" ht. Container or B. & B.	6' o.c.
↔	4	Cornus amomum/ Silky Dogwood	Whip B. & B.	6. o.c.
0	7	llex opaca/ American Holly	1"- 1 1/2" Cal., B. & B.	6' O.C.
<u></u>	6	llex verticulata/ Smooth Winterberry	50% Female, 24" to 30" ht., B. & B.	6 O.C.
\odot	3 ,	Leucothoe racemosa/ Fetter-Bush	12"-18' ht. Containter	6' D.C.
Θ	5	Rhododentron viscosum/ Swamp Azalea	12"-18" ht. Container or B. & B.	6' o.c.
\odot	5	Viburnum nudum/ Smooth Witherod	12"-18" ht. Container or	6' o.c.
TOTAL	31	The second secon	B. & B.	


DUNDALK AVENUE SERVICE GARAGE

(PLAN FOR COMPLIANCE WITH THE 10% PULE IN THE CHESAPEAKE BAY CRITICAL AREA DESIGNATION, IDA

BALTIMORE CO, MD: SCALE: AS SHOWN DATE: 5/15/20



W. DUVALL & ASSOCIATES, INC. ENGINEERS . SURVEYORS . LAND PLANNERS 530 EAST JOPPA ROAD TOWSON, MARYLAND 21204 (301) 583-9571

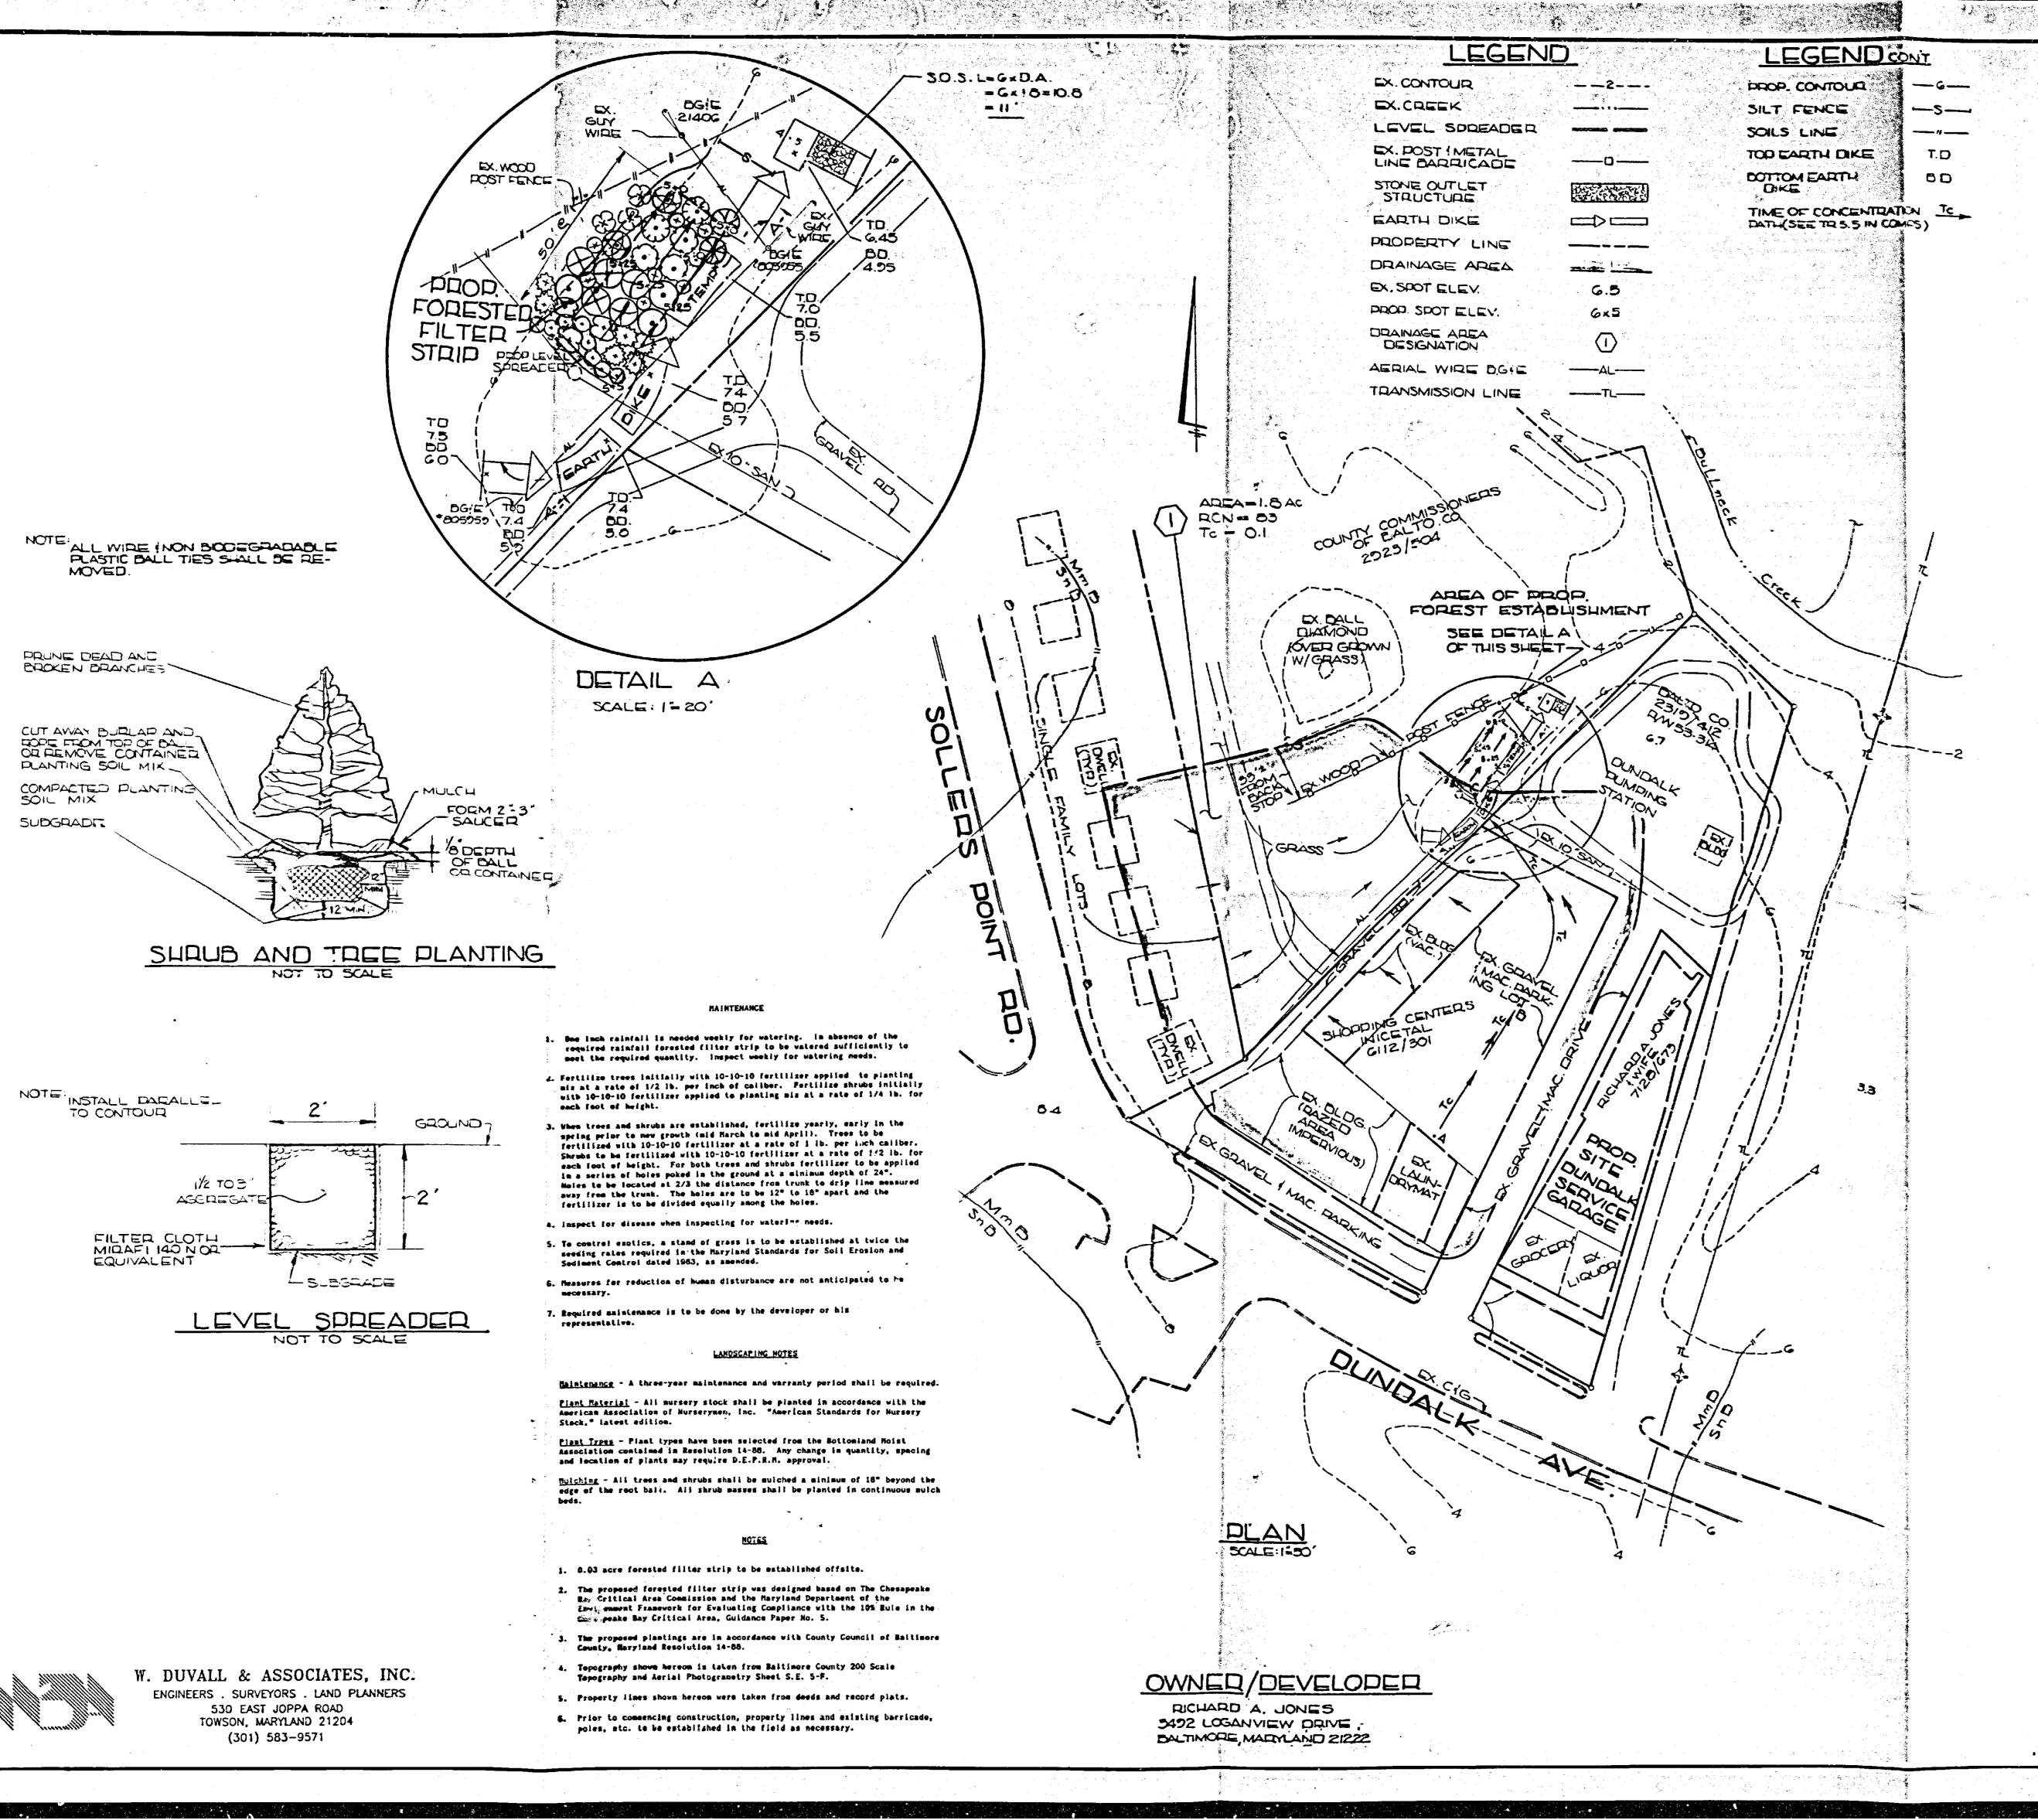



VICINITY MAP

TREE LIST		•		
Symbol	Quantity	Botanical Name/ Common Name	Size and Condition	Spacing
\otimes	3	Acer rubrum/ Red Maple	1"- 1 1/2" Cal. B. & B.	8' o-c-
\oplus	2	Betula nigra/ River Birch	1"- 1 1/2" Cal. B. & B.	8. o-c-
9	2	Carya tementosa/ Mockernut Hickory	Bare Root Seedling	8° o.c.
⊕	2	Nyssa sylvatica/ Black Gum	Whip ≠ B. & B.	8° o.c.
O	5	Platanus occidentalis/ Sycamore	Bare Root Seedling	8' o.c.
&	2	Quercus alba/ White Dak	'Whip ★ B. & B.	8, 0.c.
\odot	5	Quercus palustris/ Pin Oak	₩hip B. & B.	8° o.c.
TOTAL	17			•

* OR CONTAINER

SMALL	TREE	AND	SHRUB	LIST

Symbol	Quantity	Botanical Name/ Common Name	Remarks, Size and Condition	Spacing
•	5	Clethra alnifolia/ Sweet Pepperbush	12"-18" ht. Container or B. & B.	6' o.c.
③	3	Cornus amonum/ Silky Dogwood	Mhip B. & B.	6' a.c.
0	6	llex opaca/ American Holly	3'-4' ual., B. & B.	6' o.c.
œ	6	Ilex verticulata/ Smooth Winterberry	50% Female, 24" to 30" ht., B. & B.	6' 0.5.
O	5 .	Leucothoe racemosa/ Fetter-Bush	12"-18' ht. Containter	6. a.c.
Θ	5	Rhododentron viscosum/ Swamp Azalea	12"-18" ht. Container or B. & B.	6' o.c.
\odot	٤	Viburnum nudum/ Smooth Witherod	12"-18" ht. Container or	6' o.c.
TOTAL	26	•	B. & B.	

DUNDALK AVENUE

SERVICE GARAGE (FOREST ESTABLISHMENT

PLAN FOR COMPLIANCE WITH THE 10% PLILE IN THE CHESAPEAKE BAY CRITICAL AREA DESIGNATION, IDA)

12TH ELECTION DIST. 5CALE: AS SHOWN

DATE: 6/4/20

T 105 2

SHEET 1 OF 2

S9-523-XA Petitioner 2